



GUAM MEMORIAL HOSPITAL AUTHORITY

ATURIDÁT ESPETÁT MIMURIÁT GUÅHÅN

850 Governor Carlos Camacho Road, Tamuning, Guam 96913
Operator: (671) 647-2330 or 2552 | Fax: (671) 649-5508



November 18, 2021

AMENDMENT #3 FOR

GMHA IFB 002-2022 RENOVATION SERVICES

TO: All prospective bidders,

This Amendment is being issued to answer the following RFIs:

- 1) As per contract drawing M1.0, equipment schedule for EF#21 requires a VFD. Vendor is requesting confirmation if VFD is needed for a 1/10HP, single phase motor. If yes, please provide the sequence of operation of speed for EF#21 and provide VFD basis of design.

Please delete VFD.

- 2) Vendor is requesting clarification for the rebalancing of the air conditioning and ventilation systems for the nursing wing identified with CFMS per selected registers/diffusers/grills.

Perform TAB as design.

- 3) Contract Drawing P1.1 provides the point of connection of the new underground SWV lines. Vendor is requesting the invert elevation of the existing underground sanitary lines.

Invert elevation is not available on hand. However, please refer to attached underground piping plan, P1.1 for reference.

If any other questions/clarifications please send via telefax addressed to Mrs. Lillian Perez-Posadas, MN, RN.


Dolores F. Pangelinan,
Hospital Materials Management Administrator

Acknowledgment of Receipt: Return acknowledgment to fax number 649-3640

Company

Print Name

Signature Date

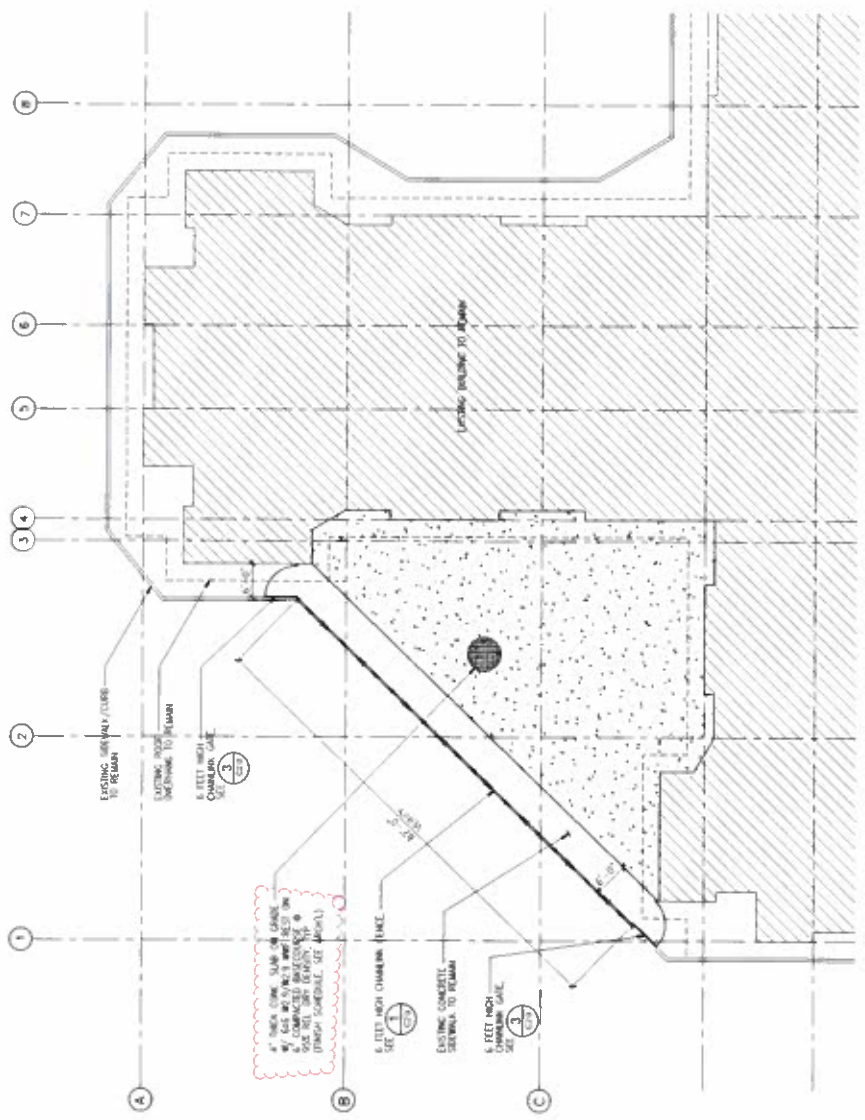


A PARTIAL SITE LAYOUT PLAN
 C1.0 SCALE 1" = 10'

ADDITIVE BID OPTION

GRAPHIC SCALE
 1" = 10'
 1" = 20'
 1" = 40'

REVISIONS	
No	Date

EMC ENGINEERING & ARCHITECTURAL INC 1800 W. MARIPOSA AVENUE, SUITE 100 TAUNTING, GUAM 96911 TEL: (671) 885-1000 FAX: (671) 885-1001 E-MAIL: info@emc-engineering.com		PROJECT ISOLATION OF WING B GME SKILLED NURSING FACILITY MARIPOSA, GUAM	TITLE PARTIAL SITE LAYOUT PLAN FINAL SUBMITTAL
PREPARED BY: JAC / HJM DRAWN BY: JAC CHECKED BY: JAC SCALE: AS SHOWN DATE: 01/27/2021 PROJECT NO: 20020116	DRAWING NO: C1.0 SHEET NO: 2 OF 35		PROJECT LOCATION: MARIPOSA, GUAM CLIENT: EMILIO A. GARZA JR. CONTRACT NO: 2019-001

REVISIONS	
No.	Date

TRSA
TRUSTEES
PLANNING
ARCHITECTURE
INTERIOR DESIGN


BIMZ
MECHANICAL INC.
 100 S. ...
 ...



PROJECT
TRUSTEES
CASE FACILITY

DESIGNED BY
TRUSTEES
CHECKED BY
DATE

DRWG. NO.
P.I.

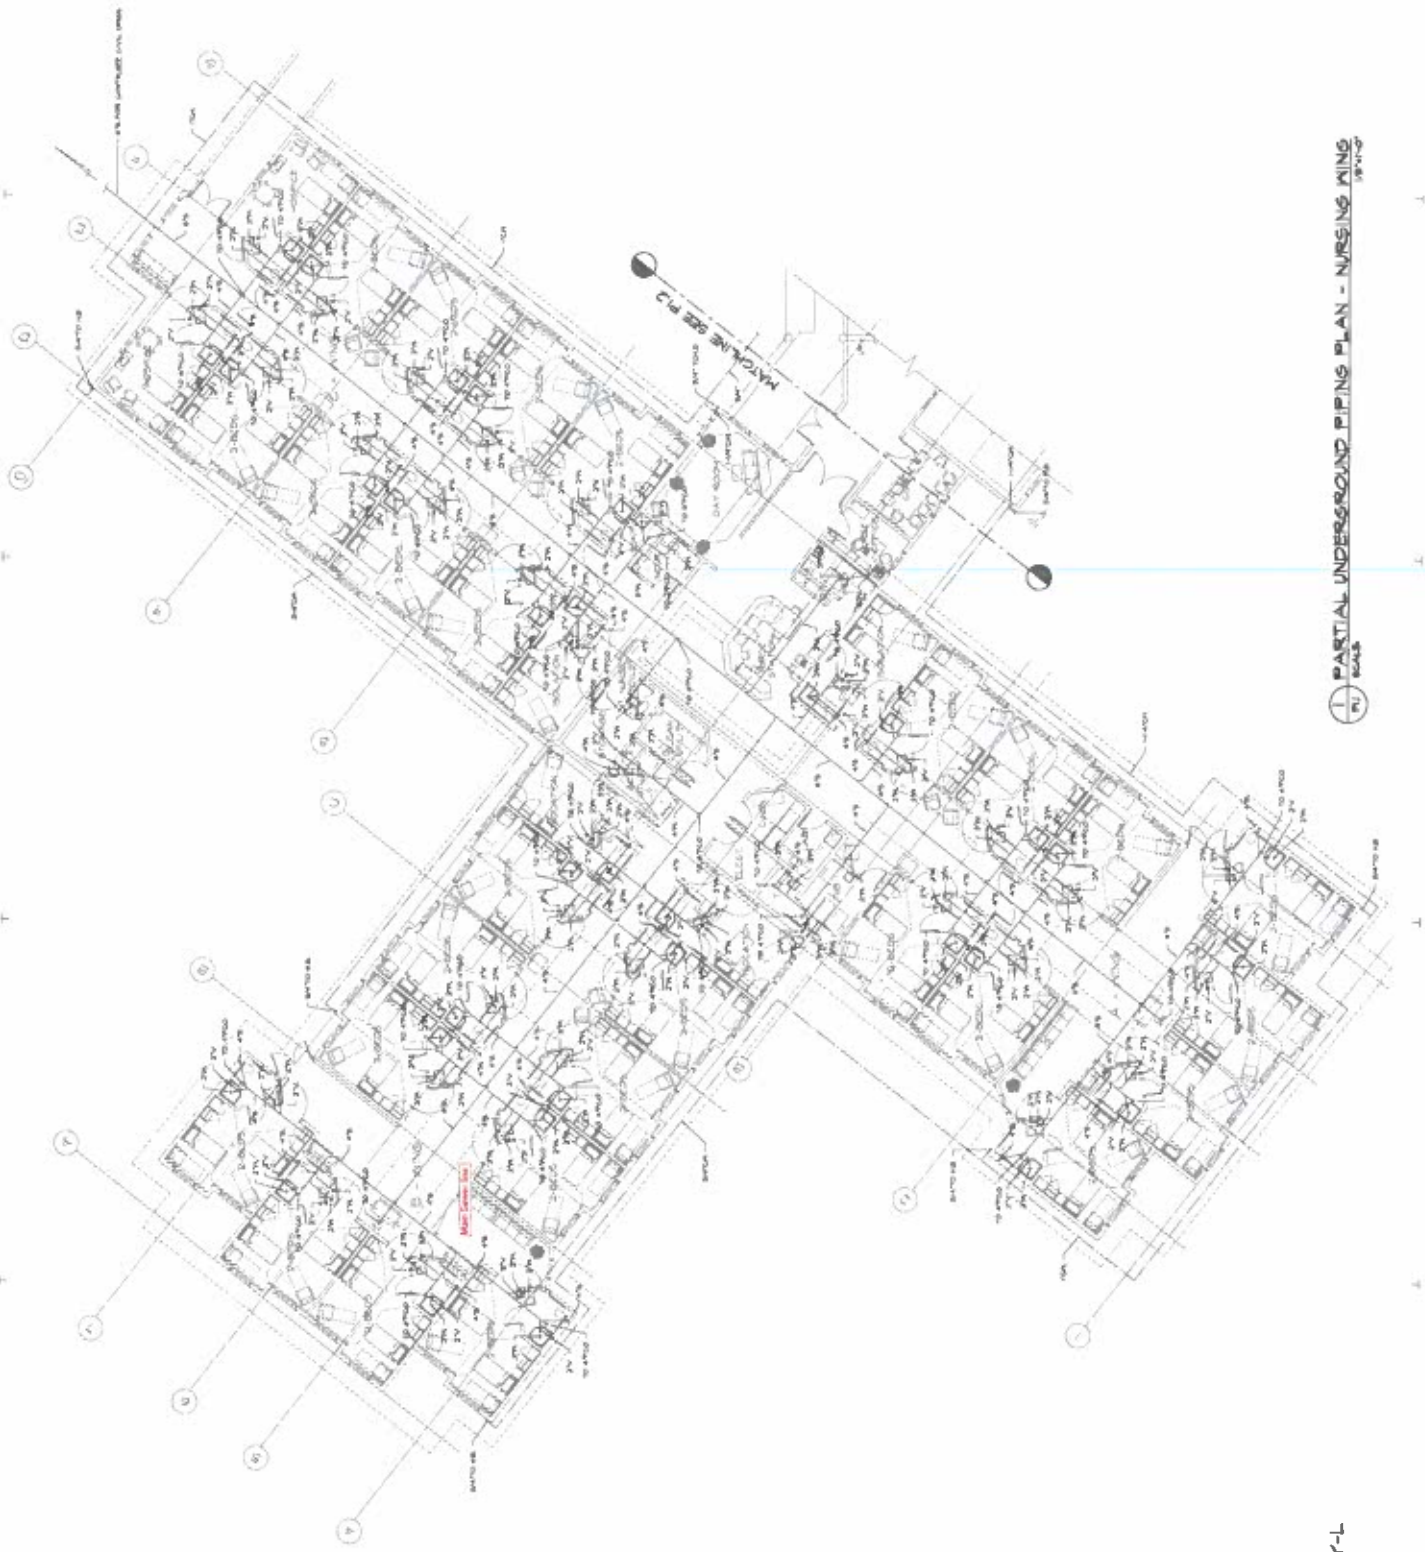

PARTIAL UNDERGROUND PIPING PLAN - NURSING WING
 (Scale 1/4" = 1'-0")